


76'-0"

REAR ELEVATION


$\frac{12}{21}$

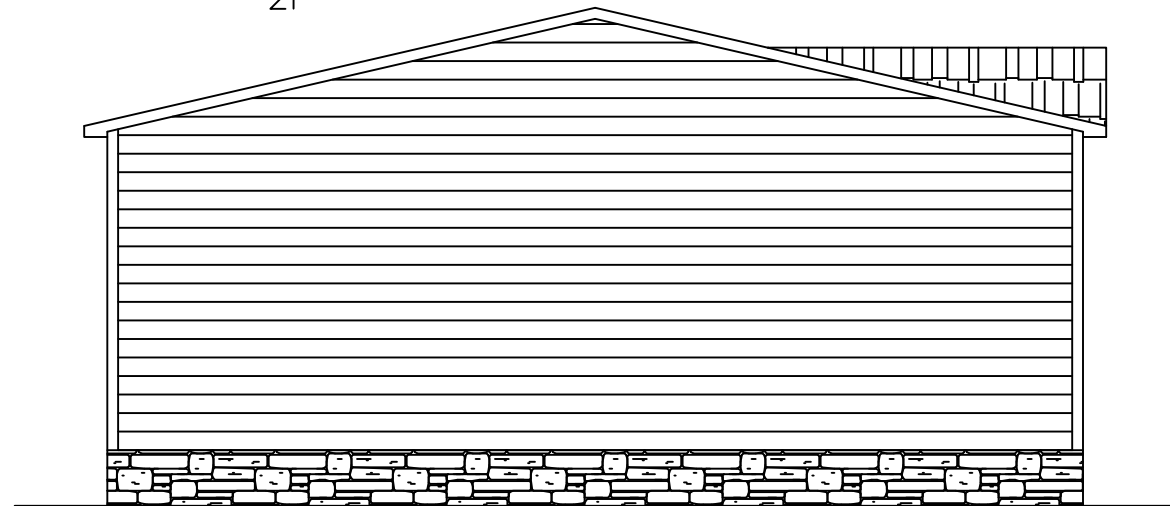

LEFT SIDE ELEVATION

26'-4"

$\frac{12}{12}$

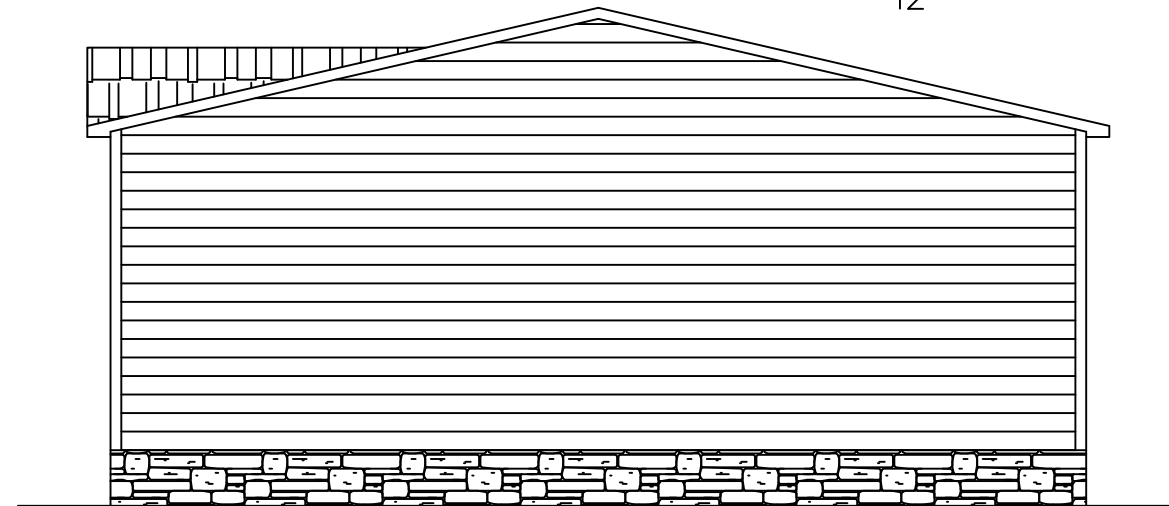

RIGHT SIDE ELEVATION

26'-4"



76'-0"

FRONT ELEVATION

REVISION	DATE	DESCRIPTION	REVISION	DATE	DESCRIPTION
1	02/25/20	UPDATED TO AS BUILT MEASUREMENTS			

SHEET:

ELEVATION

FRONT

Clayton Clayton - 934
1420 Mountain Rd, Andersonville, TN 37705
PH: 865.494.7800 FAX: 865.494.0243

HILBORN, WERNER, CARTER,
AND ASSOCIATES, INC.
1627 SOUTH MYRTLE AVE.
CLEARWATER, FL. 33756

DRAWING # 34M176

MODEL # EGL28765A

DATE: 02/05/2020

SCALE: N.T.S.

MODEL: THE EAGLE 76 (28'x76')

SERIES: EAGLE SERIES

PRODUCT DESIGNER: DANIEL C. SHELDON

STD PLAN "CONDITIONED":
2,001 FT²

REV. BY:

REV. DATE: